

19. Lakshminarasimha Temple

Place – Devarayanadurga

District : Tumakuru

Taluk : Tumakuru

Locality : Devarayanadurga

Geo – Coordinates:

Lat : 13.3735°N

Long : 77.2074°E




3D Point Cloud

History

Lakshminarasimha Temple is located at Devarayanadurga village in Tumkur taluk, Tumakuru district.

It is the second major temple in Devarayanadurga. Built in Dravidian style architecture, Yoga Narasimha Temple is located on a hillock little higher and further from Bhoga Narasimha

This temple was built by Kanthirava Narasaraja Wodeyar of Mysore, this temple was repaired in 1858 by Krishnaraja Wodeyar III. It consists of a *garbhagriha*, a *sukanasi*; a *navaranga*, a *mukhamantapa* and a porch all set in an enclosure having a *mahadvvara* surmounted by a *gopura*.

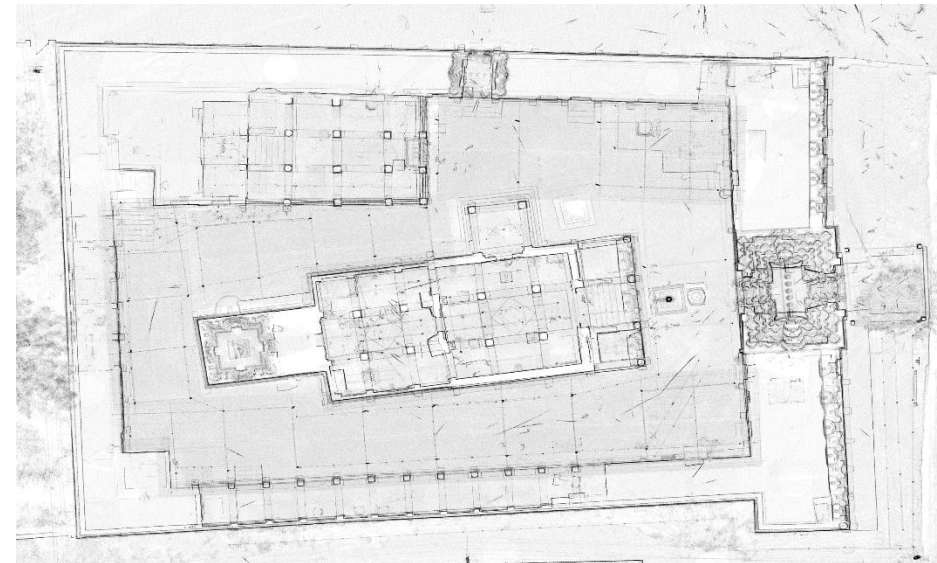

Plan